REVISIONS				
ZONE	REV	DESCRIPTION	DATE	APPROVED

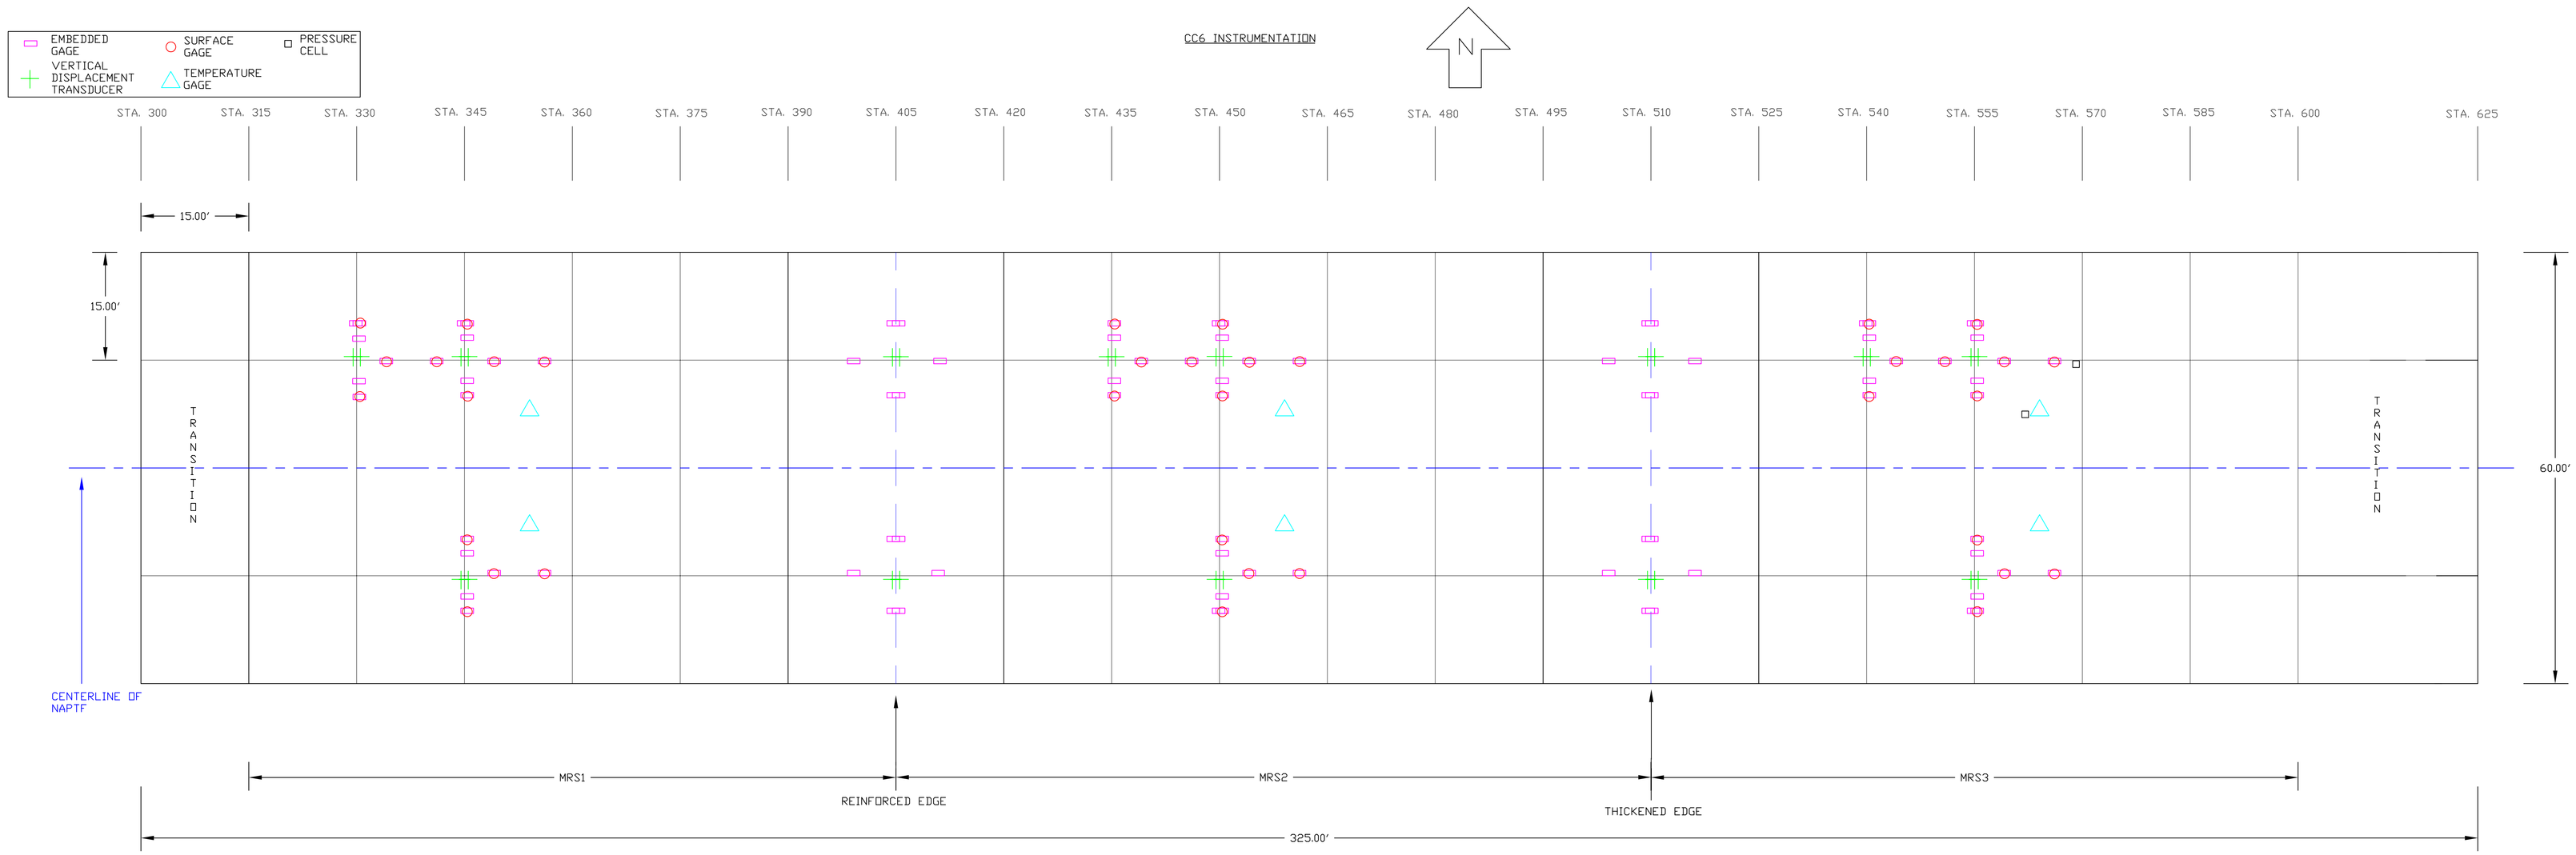

SRA INTERNATIONAL INC.
1201 NEW RD.
LINWOOD, NJ 08221

PAUL HIGGINS
PAUL_HIGGINS@SRA.COM
609-601-6800 EXT. 152

AS BUILT OF CC6 AREA SCALED TO 1.00" = 10.00'

FAA CONTRACT # DTFACT-10-D-00008
NATIONAL AIRPORT PAVEMENT TEST FACILITY

SIZE	FSCM NO.	DWG NO.	REV

SCALE		SHEET